


← Route

WINNIPESAUKEE BASIN REVISION  
17 JAN 19  
RSL/UMR  
4 REVISIONS

PRODUCED BY THE UNITED STATES GEOLOGICAL SURVEY  
CONTROL BY ..... USGS AND NOS/NOAA  
COMPILED FROM AERIAL PHOTOGRAPHS TAKEN ..... 1981  
FIELD CHECKED ..... 1984 MAP EDITED ..... 1987  
PROJECTION ..... TRANSVERSE MERCATOR  
GRID: 1000-METER UNIVERSAL TRANSVERSE MERCATOR  
10,000-FOOT STATE GRID TICKS ..... NEW HAMPSHIRE  
HORIZONTAL DATUM ..... 1987 NORTH AMERICAN DATUM  
To place on the predicted North American Datum of 1983,  
move the projection lines as shown by dashed corner ticks  
(4 meters south and 40 meters west)  
There may be private inholdings within the boundaries of any  
Federal and State reservations shown on this map  
No distinction made between houses, barns, and other buildings

**PROVISIONAL MAP**  
Produced from original  
manuscript drawings. Informa-  
tion shown as of date of  
photography.

SCALE 1:24 000  
INTERIOR—GEOLOGICAL SURVEY, RESTON, VIRGINIA—1987

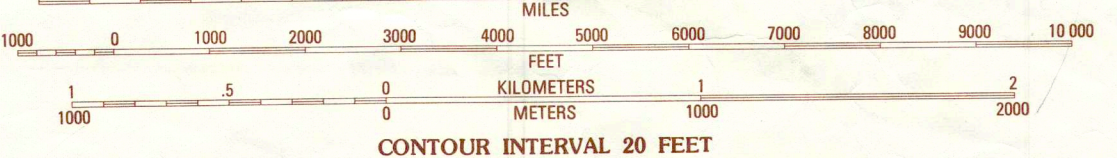

CONTOUR INTERVAL 20 FEET  
CONTROL ELEVATIONS SHOWN TO THE NEAREST 0.1 FOOT  
OTHER ELEVATIONS SHOWN TO THE NEAREST FOOT  
To convert feet to meters multiply by 3.048  
To convert meters to feet multiply by 3.2808  
THIS MAP COMPLIES WITH NATIONAL MAP ACCURACY STANDARDS  
FOR SALE BY U.S. GEOLOGICAL SURVEY  
DENVER, COLORADO 80225, OR RESTON, VIRGINIA 22092

QUADRANGLE LOCATION

|   |   |   |                   |
|---|---|---|-------------------|
| 1 | 2 | 3 | 1 Squam Mountains |
| 2 | 3 | 4 | 2 Center Sandwich |
| 3 | 4 | 5 | 3 Tamworth        |
| 4 | 5 | 6 | 4 Holderness      |
| 5 | 6 | 7 | 5 Melvin Village  |
| 6 | 7 | 8 | 6 Winnisquam Lake |
|   |   |   | 7 Lacoia          |
|   |   |   | 8 West Alton      |

ADJOINING 7.5' QUADRANGLE NAMES

ROAD LEGEND  
Improved Road .....  
Unimproved Road .....  
Trail .....  
Interstate Route U.S. Route State Route

**CENTER HARBOR, NEW HAMPSHIRE**  
PROVISIONAL EDITION 1987  
43071-F4-TF-024

98  
FOR WATER