


DETOUR SIGNING

- (A)
- (B)
- (C)
- (D)
- (E)
- (F)
- (G)
- (H)
- (I)
- (J)
- (K)
- (L)

CONSTRUCTION ZONE

NOTES:
 1. STANDARD WORK ZONE SIGNAGE IS NOT SHOWN.
 2. ALL SETUPS SHALL BE CONSISTENT WITH THE MUTCD.

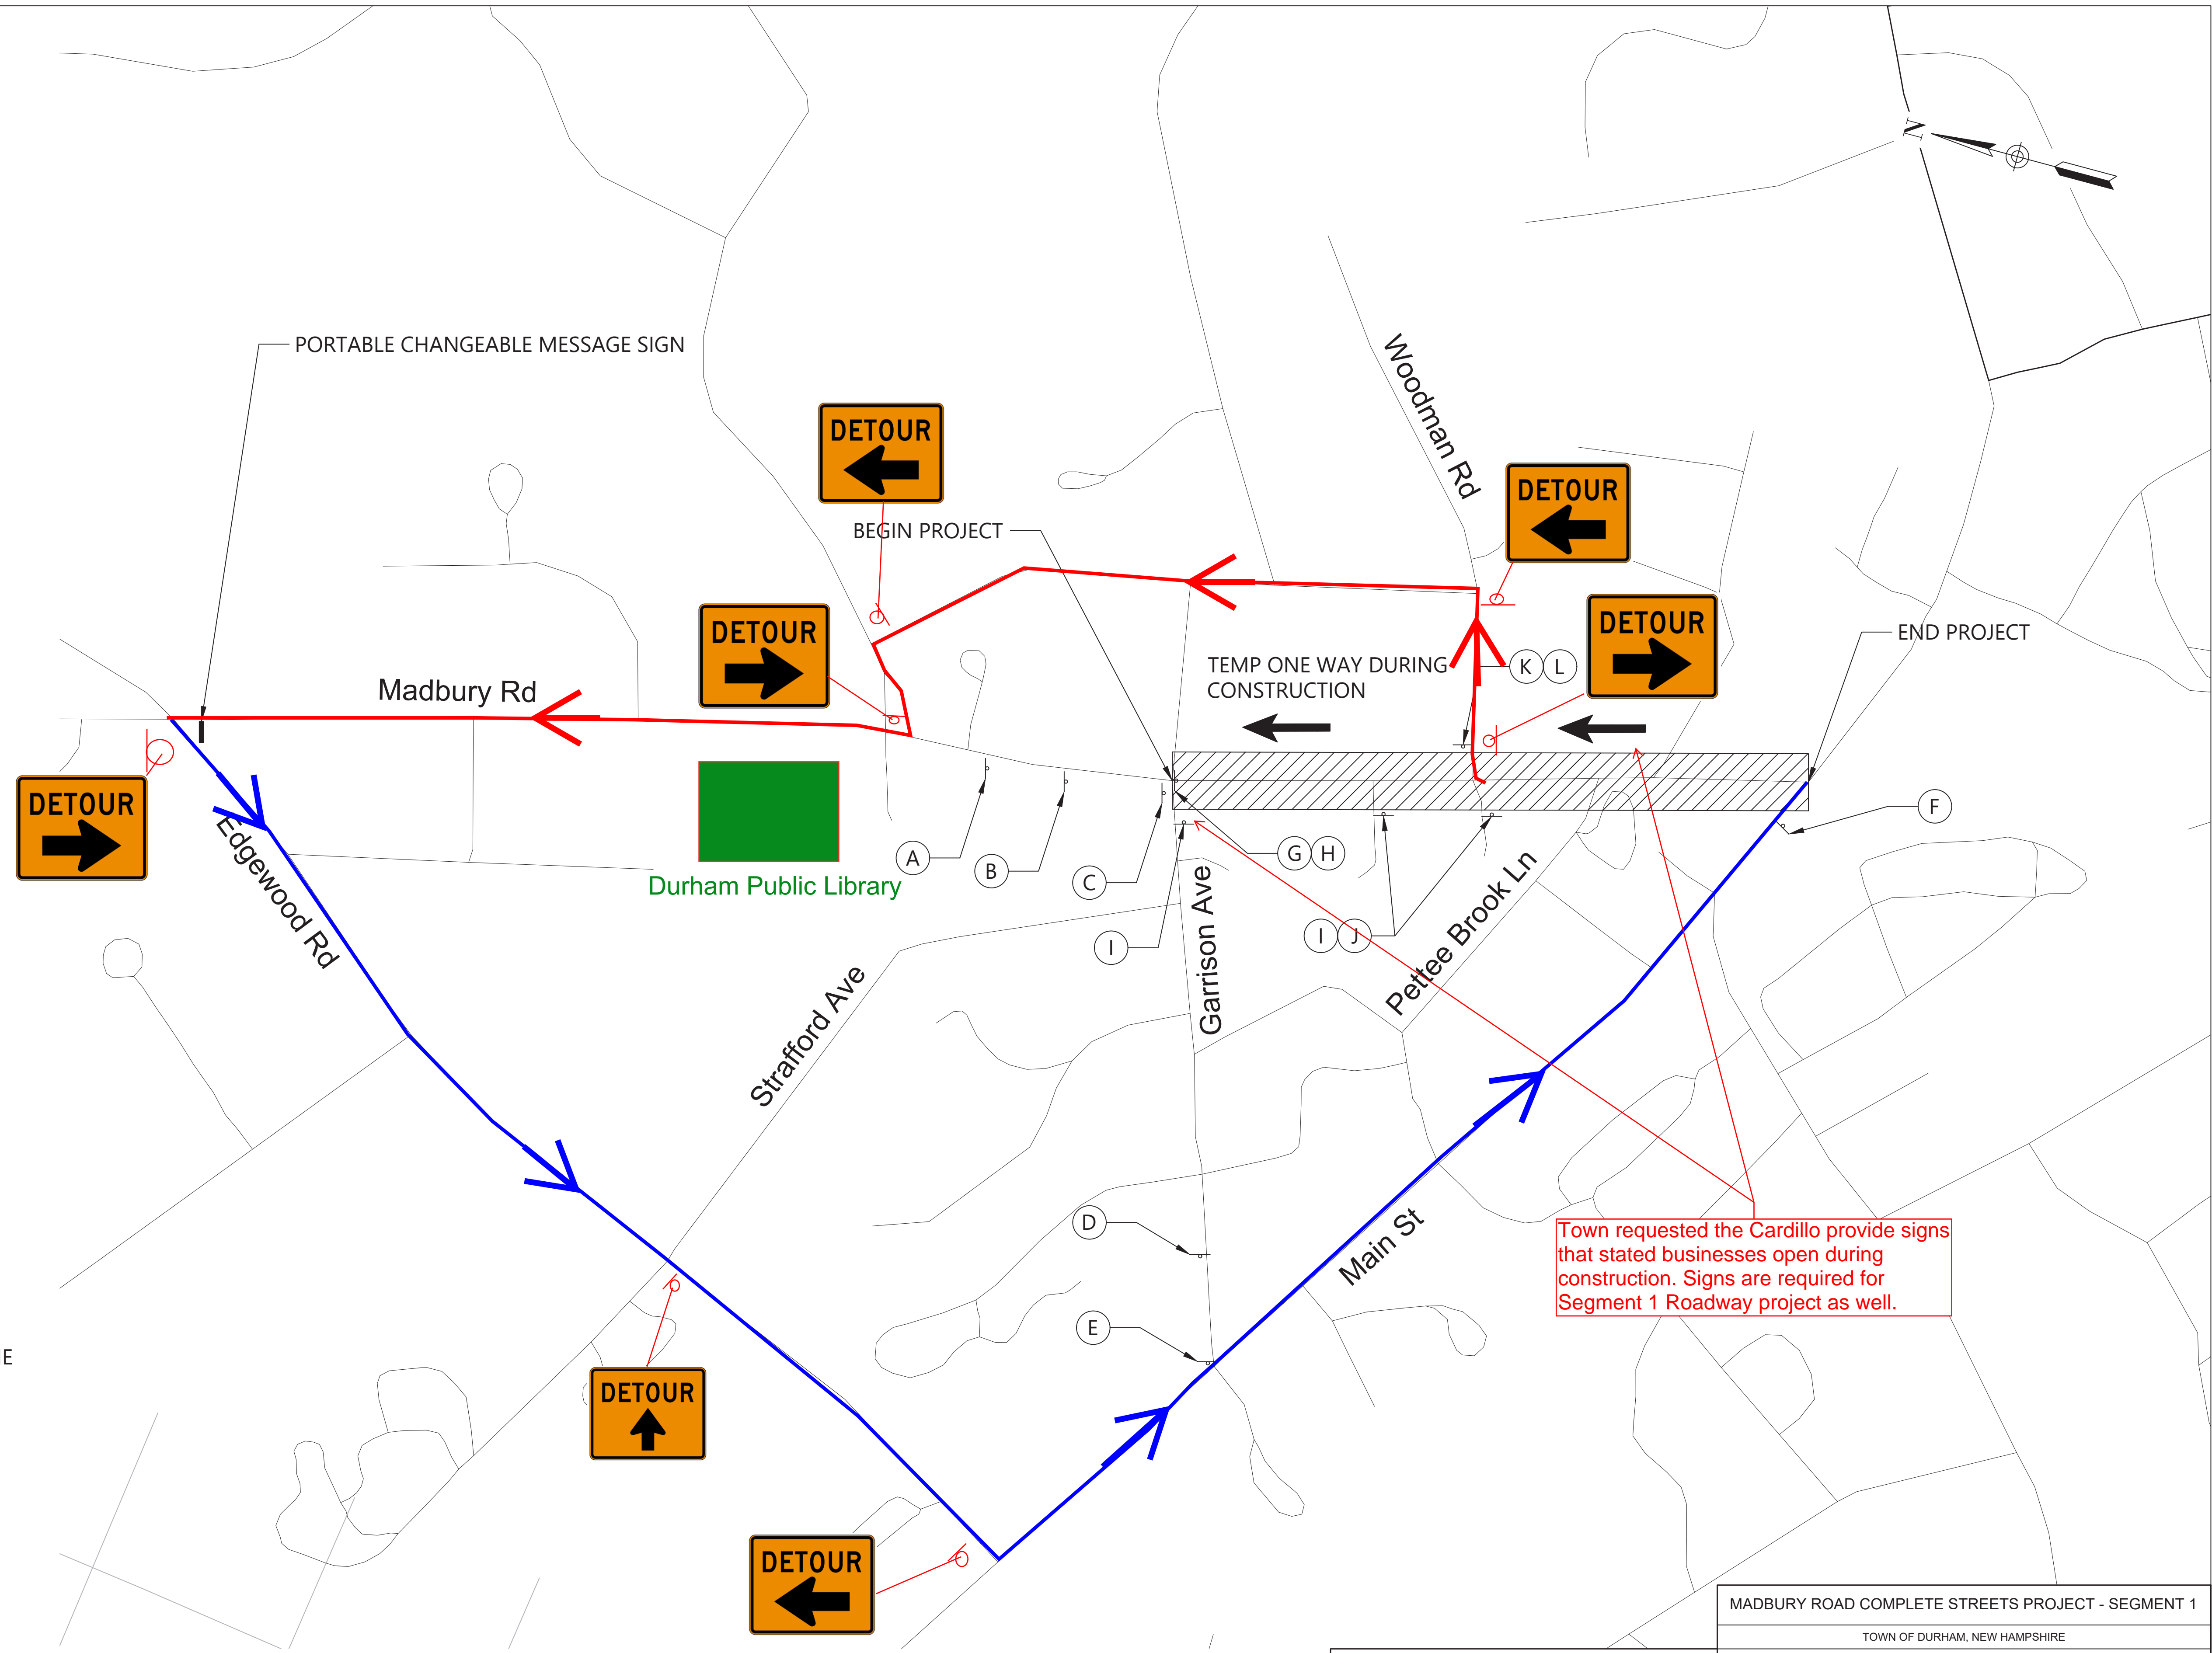

SDR PROCESSED	DATE	NUMBER	STATION	DESCRIPTION
NEW DESIGN	DATE			
SHEET CHECKED	DATE			
AS BUILT DETAILS	DATE			

MADBURY ROAD COMPLETE STREETS PROJECT - SEGMENT 1					
TOWN OF DURHAM, NEW HAMPSHIRE					
TRAFFIC CONTROL PLAN					
DATE PLOTTED	VHB PROJECT NO.	DRAWING	SEGMENT NO.	SHEET NO.	TOTAL SHEETS
3/5/2024	52830.00	52830_TCP_Phase1.dwg	1	21	71