
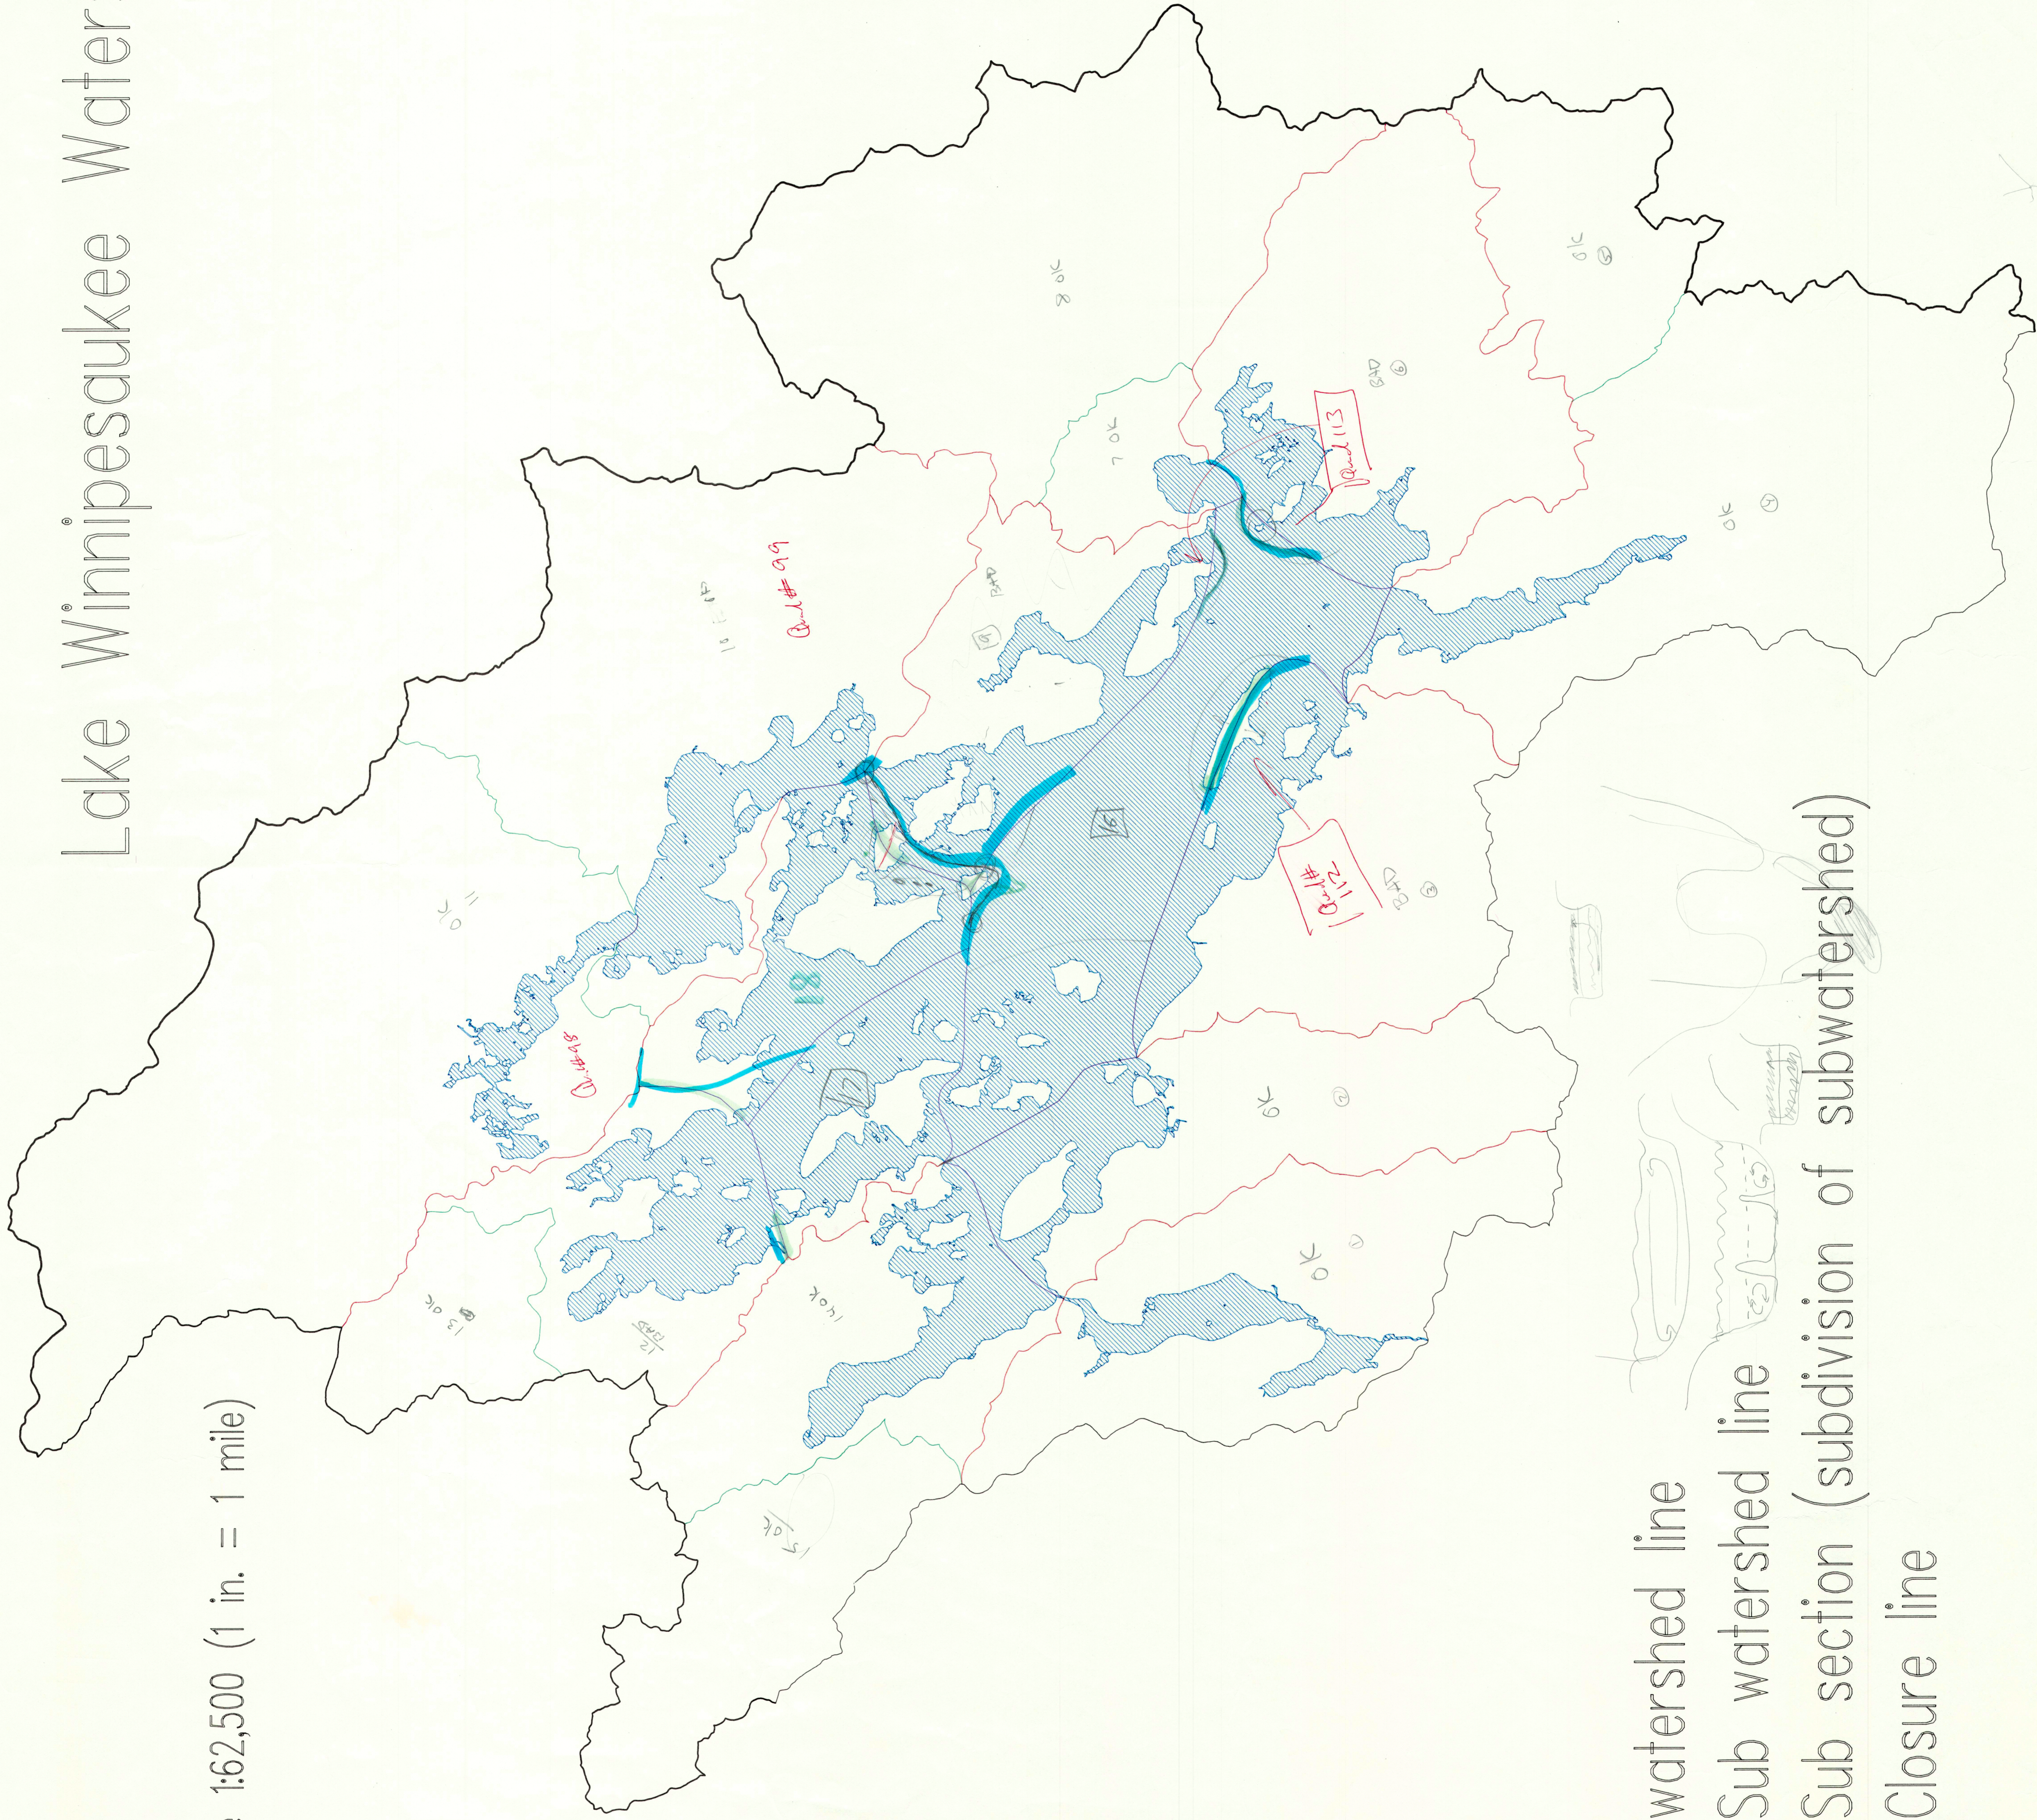
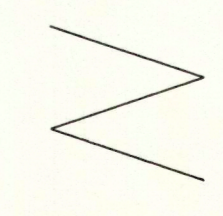
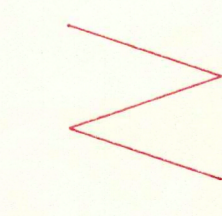
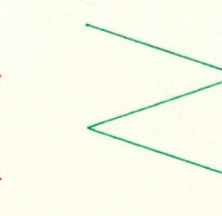


Lake Winnepesaukee Watershed

Scale 1:62,500 (1 in. = 1 mile)

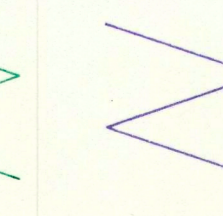

-  watershed line
-  Sub watershed line
-  Sub section (subdivision of subwatershed)
-  Closure line

Comments

1	✓
2	✓
3	X
4	✓
5	✓
6	X
7	✓
8	✓
9	X
10	✓
11	✓
12	X
13	✓
14	✓
15	X
16	X
17	X
18	Y

3 X = Rattle snake island
6 X = small island omitted.

Quads
98, 99
112, 113